

DEPARTMENT OF REGULATORY AND ECONOMIC RESOURCES (RER) BOARD AND CODE ADMINISTRATION DIVISION

MIAMI-DADE COUNTY
PRODUCT CONTROL SECTION
11805 SW 26 Street, Room 208
Miami, Florida 33175-2474
T (786) 315-2590 F (786) 315-2599

www.miamidade.goy/economy-

# **NOTICE OF ACCEPTANCE (NOA)**

Varco Pruden Buildings, a Division of BlueScope Buildings NA, Inc. 3200 Players Club Circle Memphis, TN 38125

## Scope:

This NOA is being issued under the applicable rules and regulations governing the use of construction materials. The documentation submitted has been reviewed and accepted by Miami-Dade County RER- Product Control Section to be used in Miami Dade County and other areas where allowed by the Authority Having Jurisdiction (AHJ).

This NOA shall not be valid after the expiration date stated below. The Miami-Dade County Product Control Section (In Miami Dade County) and/or the AHJ (in areas other than Miami Dade County) reserve the right to have this product or material tested for quality assurance purposes. If this product or material fails to perform in the accepted manner, the manufacturer will incur the expense of such testing and the AHJ may immediately revoke, modify, or suspend the use of such product or material within their jurisdiction. RER reserves the right to revoke this acceptance, if it is determined by Miami-Dade County Product Control Section that this product or material fails to meet the requirements of the applicable building code.

This product is approved as described herein, and has been designed to comply with the High Velocity Hurricane Zone of the Florida Building Code.

DESCRIPTION: 0.024" (min.) 3" x 24" Steel Structural Roof Panel-

**APPROVAL DOCUMENT:** Drawing No. FLVPHWR1, titled "VP HWR Panel (24" wide x 24 GA. Steel), sheets 1 through 8 of 8, prepared by Varco Pruden Buildings, a Division of BlueScope Buildings NA, Inc., last revision #1 dated November 30, 2011, signed and sealed by Larry L. Boozer, P.E., on December 07, 2011, bearing the Miami-Dade County Product Control Renewal stamp with the Notice of Acceptance number and the expiration date by the Miami-Dade County Product Control Section.

## MISSILE IMPACT RATING: Large and Small Missile Impact Resistant

**LABELING:** Each panel shall bear a permanent label with the manufacturer's name or logo, Jackson, TN and the following statement: "Miami-Dade County Product Control Approved", unless otherwise noted herein.

**RENEWAL** of this NOA shall be considered after a renewal application has been filed and there has been no change in the applicable building code negatively affecting the performance of this product.

**TERMINATION** of this NOA will occur after the expiration date or if there has been a revision or change in the materials, use, and/or manufacture of the product or process. Misuse of this NOA as an endorsement of any product, for sales, advertising or any other purposes shall automatically terminate this NOA. Failure to comply with any section of this NOA shall be cause for termination and removal of NOA.

**ADVERTISEMENT:** The NOA number preceded by the words Miami-Dade County, Florida, and followed by the expiration date may be displayed in advertising literature. If any portion of the NOA is displayed, then it shall be done in its entirety.

**INSPECTION:** A copy of this entire NOA shall be provided to the user by the manufacturer or its distributors and shall be available for inspection at the job site at the request of the Building Official.

This NOA renews NOA # 11-1215.01 and consists of this page 1, evidence submitted pages E-1 & E-2 as well as approval document mentioned above.

The submitted documentation was reviewed by Helmy A. Makar, P.E., M.S.

(MIAMI-DADE COUNTY) APPROYED Help A. Nola 09/11/2014

NOA No. 14-0715.05 Expiration Date: 01/20/2020 Approval Date: 09/11/2014 Page 1

## Varco Pruden Buildings, a Division of BlueScope Buildings NA, Inc.

# NOTICE OF ACCEPTANCE: EVIDENCE SUBMITTED

### 1. EVIDENCE SUBMITTED UNDER PREVIOUS APPROVAL #09-0917.10

### A. DRAWINGS

1. Drawing No. FLVPHWR1, titled "VP HWR Panel (24" wide x 24 GA. Steel), sheets 1 through 4 of 4, including 2.1, 2.2, 3.1, 3.2, prepared by Varco Pruden Buildings, Inc., signed and sealed by Larry L. Boozer, P.E., on November 25, 2009.

## B. TESTS

- 1. Susceptibility to Leakage Test in accordance with FM 4471, Appendix G, prepared by Force Engineering and Testing, Inc., Report No. 201-0254T-09L, dated September 09, 2009, signed and sealed by Terrence E. Wolfe, P.E.
- 2. Uniform Static Air Pressure Test in accordance with ASTM E 1592, prepared by Force Engineering and Testing, Inc., Report No. 201-0254T-09D-F, dated September 01, 2009, signed and sealed by Terrence E. Wolfe, P.E.
- 3. Wind and Wind Driven Rain Resistance of Discontinuous Roof Systems Test in accordance with TAS 100-95, prepared by Farabaugh Engineering and Testing, Inc., Report No. T220-09, dated September 07, 2009, signed and sealed by Daniel G. Farabaugh, P.E.
- 4. Large Missile Test per TAS 201, prepared by Farabaugh Engineering and Testing, Inc., Report No. T199REV1-09, dated June 11, 2009, signed and sealed by Daniel G. Farabaugh, P.E.

## C. CALCULATIONS

1. Calculation titled Varco-Pruden Buildings "VP HWR Panel (24" wide x 24 GA. Steel), 25 sheets, dated 09/14/09, prepared and signed and sealed by Larry L. Boozer, P.E.

### D. QUALITY ASSURANCE

1. By Miami-Dade County Building Code Compliance Office.

### E. MATERIAL CERTIFICATIONS

1. Tensile Test Report # W0910025, prepared by Building Research Systems, Inc., dated August 24, 2009.

Helmy A. Makar, P.E., M.S.

Product Control Unit Supervisor NOA No. 14-0715.05

Expiration Date: 01/20/2020 Approval Date: 09/11/2014

# Varco Pruden Buildings, a Division of BlueScope Buildings NA, Inc.

## NOTICE OF ACCEPTANCE: EVIDENCE SUBMITTED

### 2. EVIDENCE SUBMITTED UNDER PREVIOUS APPROVAL # 11-1215.01

### A. DRAWINGS

1. Drawing No. FLVPHWR1, titled "VP HWR Panel (24" wide x 24 GA. Steel), sheets I through 8 of 8, prepared by Varco Pruden Buildings, Inc., last revision #1 dated November 30, 2011, signed and sealed by Larry L. Boozer, P.E., on December 07, 2011.

## B. TESTS

1. None.

## C. CALCULATIONS

1. None.

### D. QUALITY ASSURANCE

1. By Miami-Dade County Department of Permitting, Environment, and Regulatory Affairs (PERA).

## E. MATERIAL CERTIFICATIONS

1. None.

#### F. OTHERS

1. Conformance Letter to the 2010 Florida Building Code, prepared by Varco Pruden Buildings, Inc., dated December 07, 2011, signed and sealed by Larry L. Boozer, P.E.

### 3. NEW EVIDENCE SUBMITTED

#### A. DRAWINGS

1. None.

## B. TESTS

None.

# C. CALCULATIONS

1. None.

### D. QUALITY ASSURANCE

1. By Miami-Dade County Department of Regulatory and Economic Resources.


#### E. MATERIAL CERTIFICATIONS


1. None.


Herny A. Makar, P.E., M.S. Product Control Unit Supervisor

NOA No. 14-0715.05

Expiration Date: 01/20/2020 Approval Date: 09/11/2014

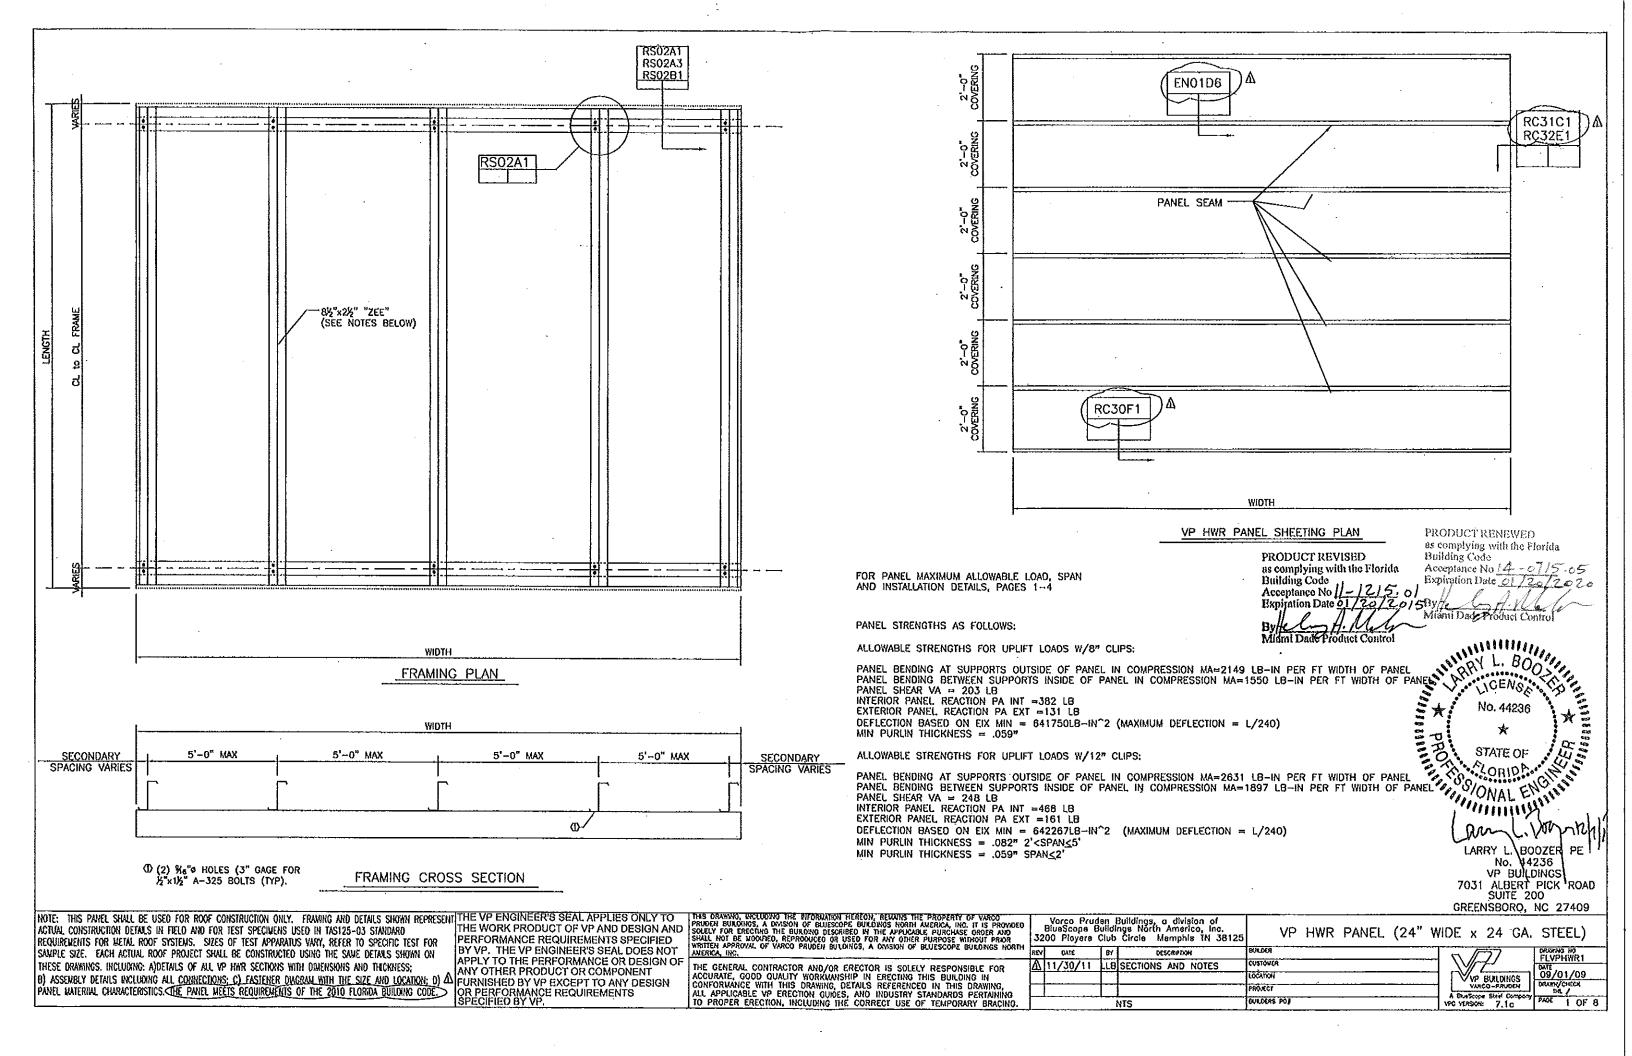

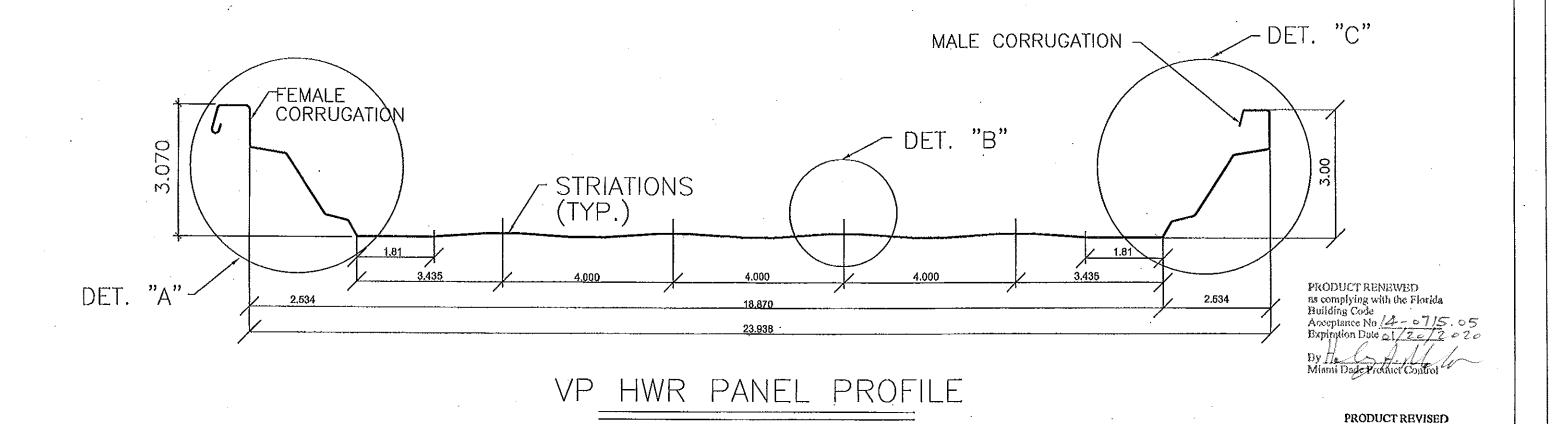

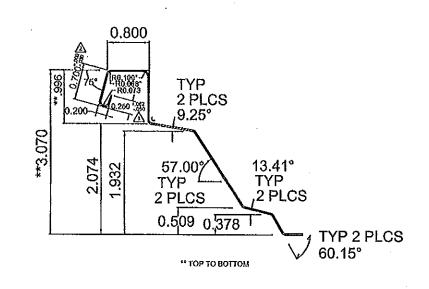

1.25" 1.25" .75' .75"

(t = 0.024" MIN.)

DETAIL

Acceptance No 11-1715.01
Expiration Date 01/20/2015 0.856 0.924 0.216 2.534 LARRY L. BOOZER PE No. 44236 VP BUILDINGS 7031 ALBERT PICK ROAD SUITE 200

as complying with the Florida

GREENSBORO, NC 27409

Building Code

DETAIL

NOTE: THIS PANEL SHALL BE USED FOR ROOF CONSTRUCTION ONLY. FRAMING AND DETAILS SHOWN REPRESENT THE VP ENGINEER'S SEAL APPLIES ONLY TO ACTUAL CONSTRUCTION DETARS IN PIELD AND FOR TEST SPECIMENS USED IN TAST25-03 STANDARD REQUIREMENTS FOR METAL ROOF SYSTEMS. SIZES OF TEST APPARATUS YARY, REFER TO SPECIFIC TEST FOR SAMPLE SIZE. EACH ACTUAL ROOF PROJECT SHALL BE CONSTRUCTED USING THE SAME DETAILS SHOWN ON THESE DRAWAYCS, INCLUDING: A)DETAILS OF ALL VP HAR SECTIONS WITH DIMENSIONS AND THICKNESS: THESE DRAYNOS, INCLUDING: A DELINES OF ALL VP HAR SCHAMS THIN DESCRIPTIONS OF THE SIZE AND LOCATION; D) ANY OTHER PRODUCT OF CONTROLLED BY VP EXCEPT TO ANY DESIGN PANEL MATERIAL CHARACTERISTICS. CHE PANEL MEETS REQUIREMENTS OF THE 2010 FLORIDA BULINIC CODE. SPECIFIED BY VP.

MINIMUM ROOF SLOPE:

1/4:12


THE WORK PRODUCT OF VP AND DESIGN AND PERFORMANCE REQUIREMENTS SPECIFIED BY VP. THE VP ENGINEER'S SEAL DOES NOT APPLY TO THE PERFORMANCE OR DESIGN OF


THE GENERAL CONTRACTOR AND/OR ERECTOR IS SOLELY RESPONSIBLE FOR ACCURATE, GOOD QUALITY WORKMANSHIP IN ERECTING THIS BUILDING IN CONFORMANCE WITH THIS DRAWING, DETAILS REFERENCEO IN THIS DRAWING, ALL APPLICABLE VP ERECTION QUOES, AND INDUSTRY STANDARDS PERTAINING TO PROPER ERECTION, INCLUDING THE CORRECT USE OF TEMPORARY BRACING.

Vorco Pruden Buildings, a division of BlueScope Buildings North America, Inc. 3200 Players Club Circle Memphis TN 38125 DESCRIPTION CATE

VP HWR PANEL (24" WIDE x 24 GA, STEEL)

CULCER KHO HO FLVPHWR1 11/30/11 LLB SECTIONS AND NOTES <sup>QATE</sup>09/01/09 VP BUILDINGS LOCATION DRUM/CHECK THE / FAGE 2 OF 8 PACUECT BUALOURS PO!

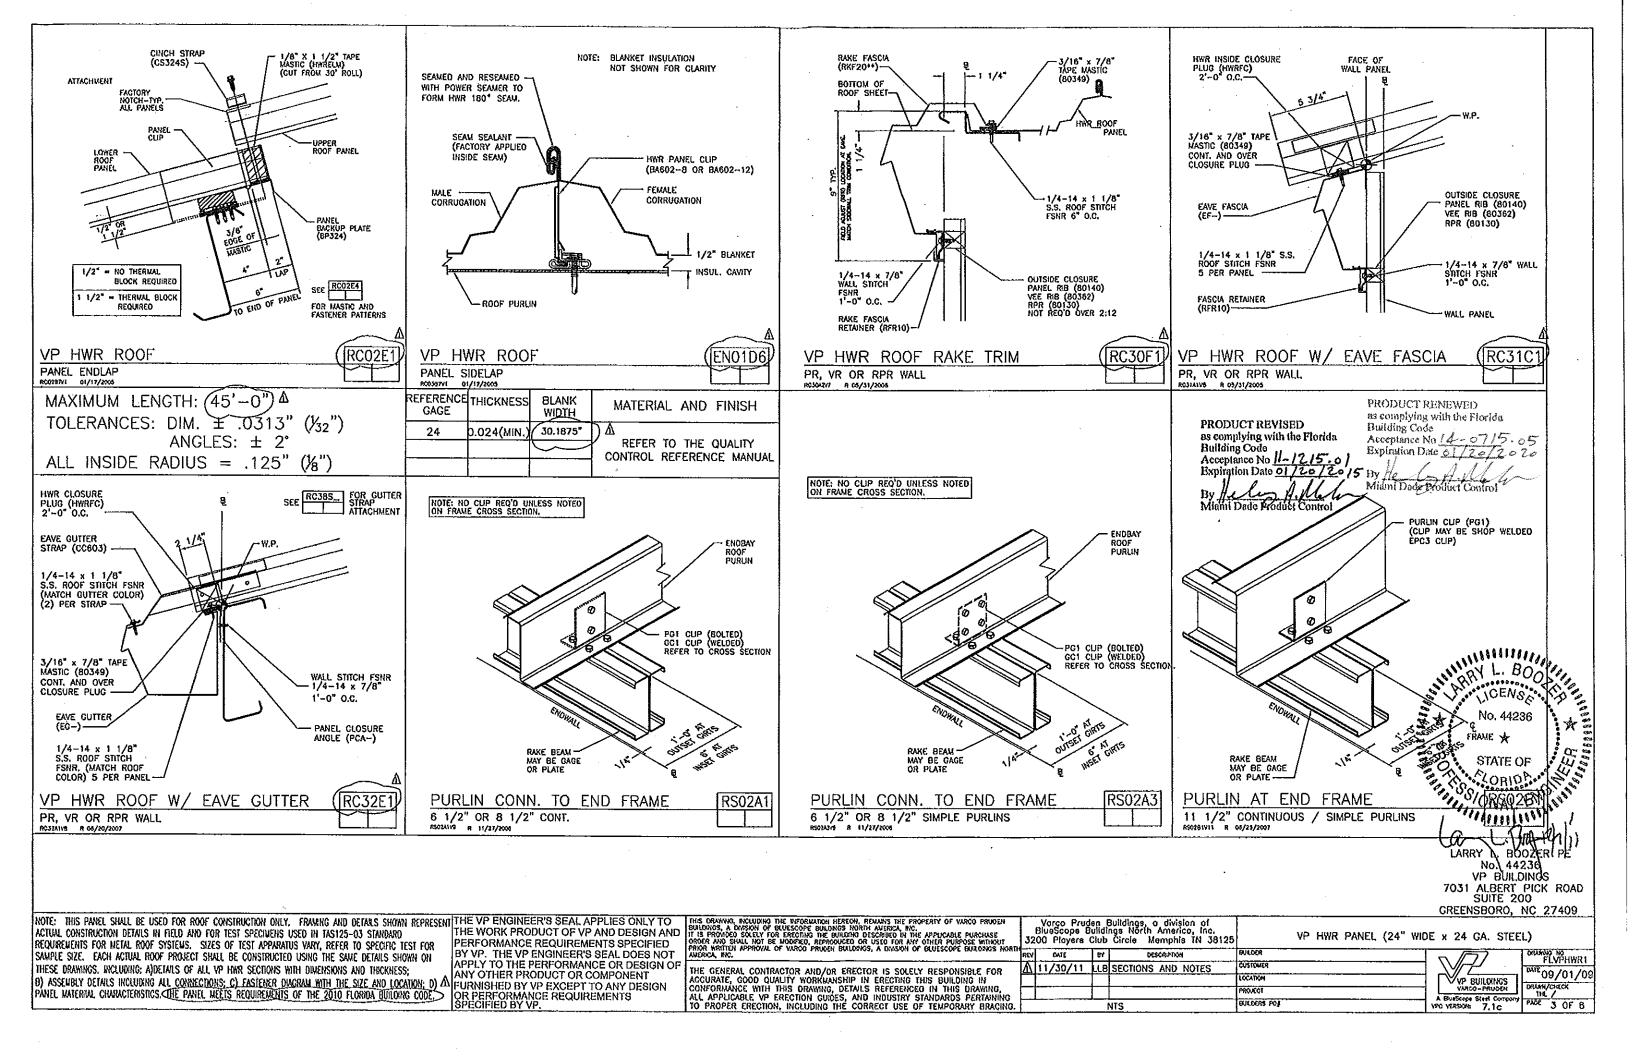

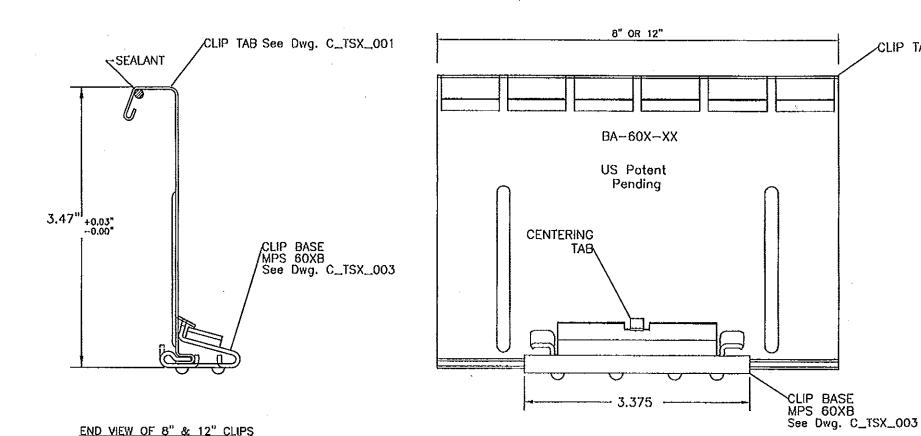

VP HWR PANEL CLIP DETAILS AND SPECIFICATIONS

NOTE: MAT'L BASE G-90 GALVANIZED 50 KSI MIN YLD .064 THICK MAT'L CLIP TAB G-90 GALVANIZED GALVALUME 50 KSI MIN YLD .037 THICK, PRODUCT RENEWED

as complying with the Florida Building Code Acceptance No 14 - 07/5.05
Expiration Date 01/20/2020

By He Control Minus Dade Product Control

PRODUCT REVISED as complying with the Florida Ruilding Code
Acceptance No 11-12/5.0/
Expiration Date 01/20/20/5

VP BUILDINGS

7031 ALBERT PICK ROAD SUITE 200 GREENSBORO, NC 27409

VP BUILDINGS

FLVPHVR1

DATE 09/01/09

DRUXK/CHECK

NOTE: THIS PANEL SHALL BE USED FOR ROOF CONSTRUCTION ONLY. FRAVING AND DETAILS SHOWN REPRESENTHE VP ENGINEER'S SEAL APPLIES ONLY TO ACTUAL CONSTRUCTION DETAILS IN FIELD AND FOR TEST SPECIMENS USED IN TAS125-03 STANDARD REQUIREMENTS FOR METAL ROOF SYSTEMS. SIZES OF TEST APPARATUS VARY, REFER TO SPECIFIC TEST FOR SAMPLE SIZE. EACH ACTUAL ROOF PROJECT SHALL BE CONSTRUCTED USING THE SAME DETAILS SHOWN ON THESE DRAWINGS, INCLUDING: A)DETAILS OF ALL VP KKR SECTIONS WITH DIMENSIONS AND THICKNESS; B) ASSEMBLY DETAILS INCLUDING ALL CONNECTIONS: C) FASTENER DIAGRAM WITH THE SIZE AND LOCATION; DYPANEL MATERIAL CHARACTERISTICS. THE PANEL MEETS REQUIREMENTS OF THE 2010 FLORIDA BULIONIC COOF.

EATHE VP ENGINEER'S SEAL APPLIES ONLY TO
THE WORK PRODUCT OF VP AND DESIGN AND
PERFORMANCE REQUIREMENTS SPECIFIED
BY VP. THE VP ENGINEER'S SEAL DOES NOT
APPLY TO THE PERFORMANCE OR DESIGN OF
ANY OTHER PRODUCT OR COMPONENT
FURNISHED BY VP EXCEPT TO ANY DESIGN
OR PERFORMANCE REQUIREMENTS
SPECIFIED BY VP.


THE GENERAL CONTRACTOR AND/OR ERECTOR IS SOLELY RESPONSIBLE FOR ACCURATE, GOOD QUALITY WORKWAYSHIP IN ERECTING THIS BUILDING IN CONFORMANCE WITH THIS DRAWING, DETAILS REFERENCED IN THIS DRAWING, ALL APPLICABLE VP ERECTION GUIDES, AND INDUSTRY STANDARDS PERTAINING TO PROPER ERECTION, INCLUDING THE CORRECT USE OF TEMPORARY BRACING.

t	Vo	rco Pru	den E	Bulldings	, a divisto	n of
	Blu	eScope	Buildir	ngs Nos	In America	, inc,
	3200	Players	Club	Circle	Memphis	TN 38125
ľ	REV	DATE	BY		DESCRIPTION	

CLIP TAB See Dwg. C\_TSX\_001

VP HWR PANEL (24" WIDE x 24 GA. STEEL)

ł	REV	DATE	GY	DESCRIPTION	BURDER		Γ
4	Δ	11/30/11		SECTIONS AND NOTES	CUSTOVER		7
ľ	=				LOCATION	<del></del>	ן ר׳
ŀ				*** ** *** *** *** *** *** *** *** ***	PROJECT		▎▁
İ	NTS				BULDEAS POJ		A 80 190 Y

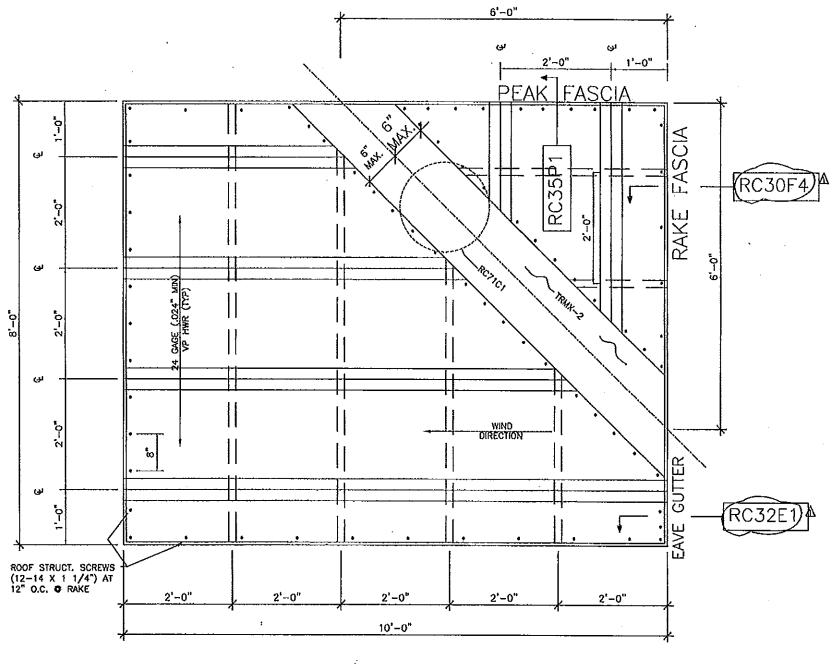

VP HWR systems consists of 0.024" (min.) 3" x 24" steel structural roof panel. VP HWR panels are factory-formed and field-machined seamed in place yielding a single unit membrane. Thermal compensating conceded clips connect the panels to secondary structural members which with sealants. mastics, closures, trim and flashing provide a weathertight and finished appearance. VP HWR panels provide 24" wide net coverage and have 3" high major ribs. Minimum roof pitch is 0.25: 12.

Roof panel mechanical properties:

Galvalume and galvanized steel coil used in roll formed or press broken roof covering generally will be material based on the requirements of ASTM A792 SS, Class 1 or 4 Gr. 50 for galvolume and A653 for galvanized. The minimum yield strength Fy = 53,300 psi, tensile strength Fu = 65000 psi.

Roof panel coatings and/or finishes consist of the following:

- (1.) Galvalume AZ55 an aluminum-zinc alloy coating thickness of approximately .0018" applied to both sides of base metal.
- (2.) Galvalume AZ50 an aluminum-zinc alloy coating thickness of approximately .0016" applied to both sides of base metal.
- (3.) Galvanized G90 a zinc coating thickness of approximately .0015" applied to both sides of base metal.
- (4.) Galvolume AZ55 may or may not have a KXL coating.
- (5.) Galvalume AZ50 and Galvanized G90 must have a KXL coating.

Fasteners:

Exposed fasteners are self drilling, stainless steel-capped with integral sealing washer. Color of fastener heads match the roof panel finish when specified. Concealed fasteners for roof clip to roof secondary are self drilling. Location size and quantities as specified in details. Fasteners are manufactured by ITW Buildex, 1349 West Manor Ave., Itasca, IL 60143

Closures, Mastics, and Sealants:

Closures, formed to match roof panel profiles are supplied as required or specified to provide weathertightness. Closures are of a coated coil material, normally EPDM

ethylene-propylene-duene-monomre) in a groy or

neutral color. Closures are manufactured by Hanna Rubber Cmpany Inc. 1511 Baltimore Ave. Kansas City, MO 64108. Preformed tape mostics, and/or non-skinning tube sealants are supplied for the sidelaps and endlaps of all Varco-Pruden roof coverings. Tape mostic is preformed butyl rubber-based compound. The compound is non-hardening, non-corrosive to metal and has excellent adhesion properties. Tape mostic is white or light gray in color. Tape mostic is maunufactured by Sika Corp. 30800 Stephenson Hwy. Madison Heights, Mi 48071.

Tube section is a synthetic elastomer based material. Section color is gray or bronze. Tube section is manufactured by Sika Corp. 30800 StephensonHwy, Madison Heights, MI 48071.

> PRODUCT RENEWED as complying with the Florida Building Code Acceptance No 14-07/5.05

Miami Dade Product Control

Expiration Date 01/20/2020

PRODUCT REVISED as complying with the Florida

of STAIL STA Acceptance No 11-12/5 Expiration Date 01/20/20/5

LARRY L. BOOZER PE No. 44236 VP BUILDINGS 7031 ALBERT PICK ROAD SUITE 200

WHALL BOOK RRY L. BOOS

GREENSBORO, NC 27409

NOTE: THIS PANEL SHALL BE USED FOR ROOF CONSTRUCTION ONLY, FRANKING AND DETAILS SHOWN REPRESENT THE VP ENGINEER'S SEAL APPLIES ONLY TO ACTUAL CONSTRUCTION DETAILS IN FIELD AND FOR TEST SPECIMENS USED BY TAST25-03 STANDARD REQUIREMENTS FOR WETAL ROOF SYSTEMS. SIZES OF TEST APPARATUS WARY, REFER TO SPECIFIC TEST FOR SAMPLE SIZE. EACH ACTUAL ROOF PROJECT SHALL BE CONSTRUCTED USING THE SAME DETAILS SHOWN ON THESE DRAWINGS, INCLUDING: A)DETAILS OF ALL VP HAR SECTIONS WITH DIMENSIONS AND TRACKNESS: B) ASSEMBLY DETAILS INCLUDING ALL CONNECTIONS; C) FASTENER DIAGRAM WITH THE SIZE AND LOCATION; D) A PANEL MATERIAL CHARACTERISTICS. THE PANEL NEETS REQUIREMENTS OF THE 2010 FLORIDA BUILDING CODE.

APPLY TO THE PERFORMANCE OR DESIGN OF ANY OTHER PRODUCT OR COMPONENT FURNISHED BY VP EXCEPT TO ANY DESIGN OR PERFORMANCE REQUIREMENTS ISPECIFIED BY VP.


THE VP ENGINEER'S SEAL APPLIES ONLY TO THE WORK PRODUCT OF VP AND DESIGN AND SECTION OF BUISCOSE BULGINGS NORTH MERICA, INC. IT IS PROMOTHE WORK PRODUCT OF VP AND DESIGN AND SCIEVE OF ERECING THE BUILDING DISCRETE BUTCHES IN PROVIDE A PRODUCT OF USE BUTCHES ON THE PROVIDED AND THE PROPERTY OF VICE PROPERTY OF VICE PROVIDED BY VP. THE VP ENGINEER'S SEAL DOES NOT


THE GENERAL CONTRACTOR AND/OR ERECTOR IS SOLELY RESPONSIBLE FOR ACCURATE, GOOD QUALITY WORKLANSHIP IN ERECTING THIS BUILDING IN CONFORMANCE WITH THIS DRAWING, DETAILS REFERENCED IN THIS DRAWING, ALL APPLICABLE UP ERECTION GUIDES, AND INDUSTRY STANDARDS PERTAINING TO PROPER ERECTION, INCLUDING THE CORRECT USE OF TEMPORARY BRACING

Vorco Pruden Buildings, a division of BlueScope Buildings North America, Inc. 3200 Players Club Circle Memphis TN 38125 BY 11/30/11 LLB SECTIONS AND NOTES

VP HWR PANEL (24" WIDE x 24 GA. STEEL)

CUSTOMER 09/01/09 DRXW/CHECK THL/ VP BUILDINGS LOCATION PROJECT

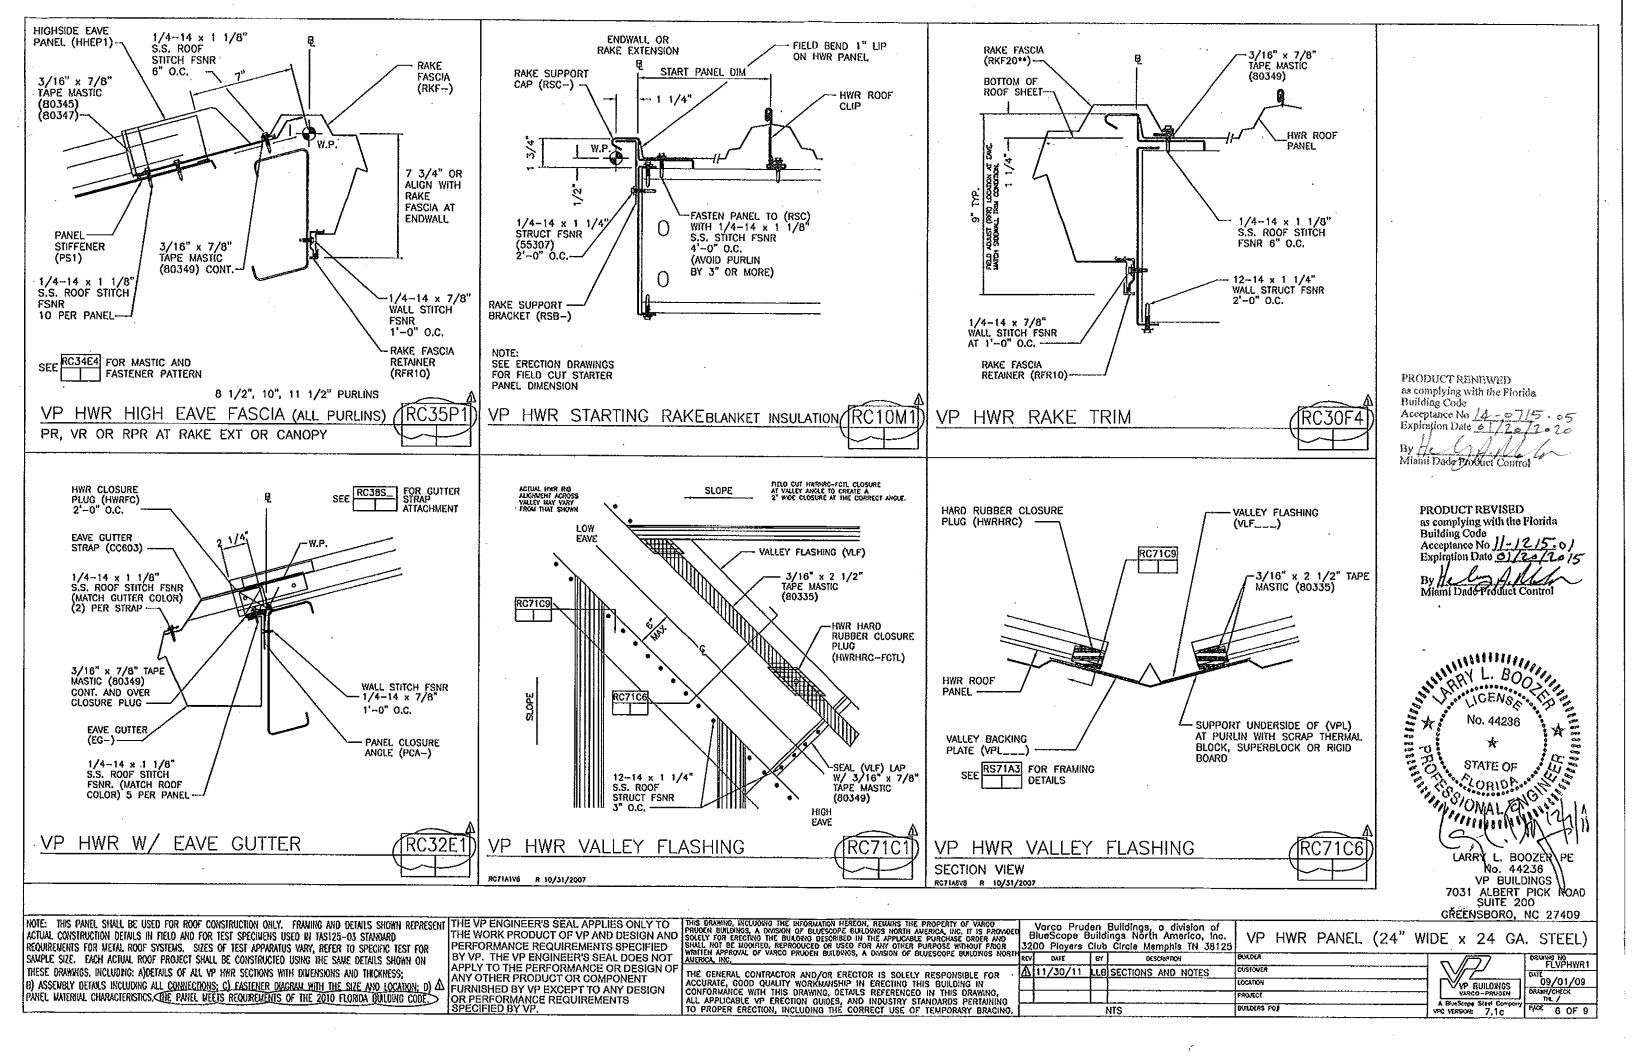

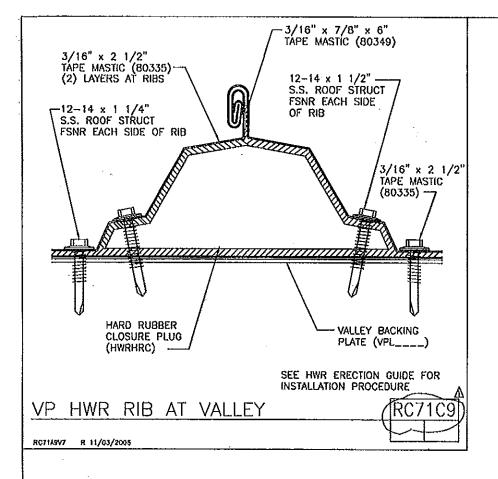

PRODUCT REVISED as complying with the Florida Building Code Acceptance No //- 12/5.0/ Expiration Date 01/20/20/5

PRODUCT RENEWED us complying with the Florida Building Code Acceptance No 14-0715.05

Expiration Date 01/20/2010

Miami Dage Product Control

No. 44236

STATE OF

ONALENGE

ONALE LARRY L. BOOZER PE No. 44236

VP BUILDINGS 7031 ALBERT PICK ROAD SUITE 200

FLVPHWR1

PAGE 7 OF 8

GREENSBORO, NC 27409

THIS DRAWING, INCLUDING THE INFORMATION REPEON, REMAINS THE PROPERTY OF VARCO PRUDEN BULDAYOS, A DYNSON OF BLUESCOPE BUILDINGS NORTH AMERICA, INC. IT IS PROMOCO SOLELY FOR ERECTING THE BUILDING DESCRIBED IN THE APPUCABLE PURCHASE ORDER AND SHALL NOT BE VOORTBEO, REPROJUCED OF USED FOR ANY OTHER PURPOSE WITHOUT PRIOR WRITTEN APPROVAL OF VARCO PRUDEN BULDAYOS, A DYNSON OF BLUESCOPE BULDAYOS NORTH THE CENERAL CONTRACTOR AND/OR ERECTOR IS SOLELY RESPONSIBLE FOR ACCURATE, GOOD QUALITY WORKMANSHIP IN ERECTING THIS BUILDING IN CONFORMANCE WITH THIS DRAWING, DETAILS REFERENCED IN THIS DRAWING, ALL APPLICABLE UP ERECTION GUIDES, AND INDUSTRY STANDARDS PERTAINING TO PROPER ERECTION, INCLUDING THE CORRECT USE OF TEMPORARY BRACING.

Varco Pruden Buildings, a division of BlueScope Buildings North America, Inc 3200 Pio 11/30

x 24 GA. STEEL)

		Circle Memphis TN 38125	VP HWR PANEL (24	WIDE x 24 G
	87	DESCRIPTION	BOADER	5 // 77
/11	LL8	SECTIONS AND NOTES	CUSTORER	<del></del>
			LOCATION	VP BULOINGS
			PROJECT	VARCO-PRUDEN
		NTS	BULDERS PO!	A Styliscope Steel Compo- VPC VERSON: 7.10

NOTE: THIS PAREL SKALL BE USED FOR ROOF CONSTRUCTION ONLY. FRANING AND DETAILS SHOWN REPRESENT THE VP ENGINEER'S SEAL APPLIES ONLY TO ACTUAL CONSTRUCTION DETAILS IN FIELD AND FOR TEST SPECIMENS USED IN TAS125-03 STANDARD REQUIREMENTS FOR METAL ROOF SYSTEMS. SIZES OF TEST APPARATUS VARY, REFER TO SPECIFIC TEST FOR SAMPLE SIZE. EACH ACTUAL ROOF PROJECT SHALL BE CONSTRUCTED USING THE SAME DETAILS SHOWN ON THESE DRAWINGS. INCLUDING: A)DETAILS OF ALL VP HIRR SECTIONS WITH DIMENSIONS AND THICKNESS: B) ASSENBLY DETAILS INCLUDING ALL CONNECTIONS; C) FASTEHER DIAGRAM WITH THE SIZE AND LOCATION; D) A FURNISHED BY VP EXCEPT TO ANY DESIGN PANEL MATERIAL CHARACTERISTICS. THE PANEL MEETS REQUIREMENTS OF THE 2010 FLORIDA BUILDING CODE.

OR PERFORMANCE REQUIREMENTS

PERFORMANCE REQUIREMENTS SPECIFIED BY VP. THE VP ENGINEER'S SEAL DOES NOT APPLY TO THE PERFORMANCE OR DESIGN OF ANY OTHER PRODUCT OR COMPONENT OR PERFORMANCE REQUIREMENTS SPECIFIED BY VP.

